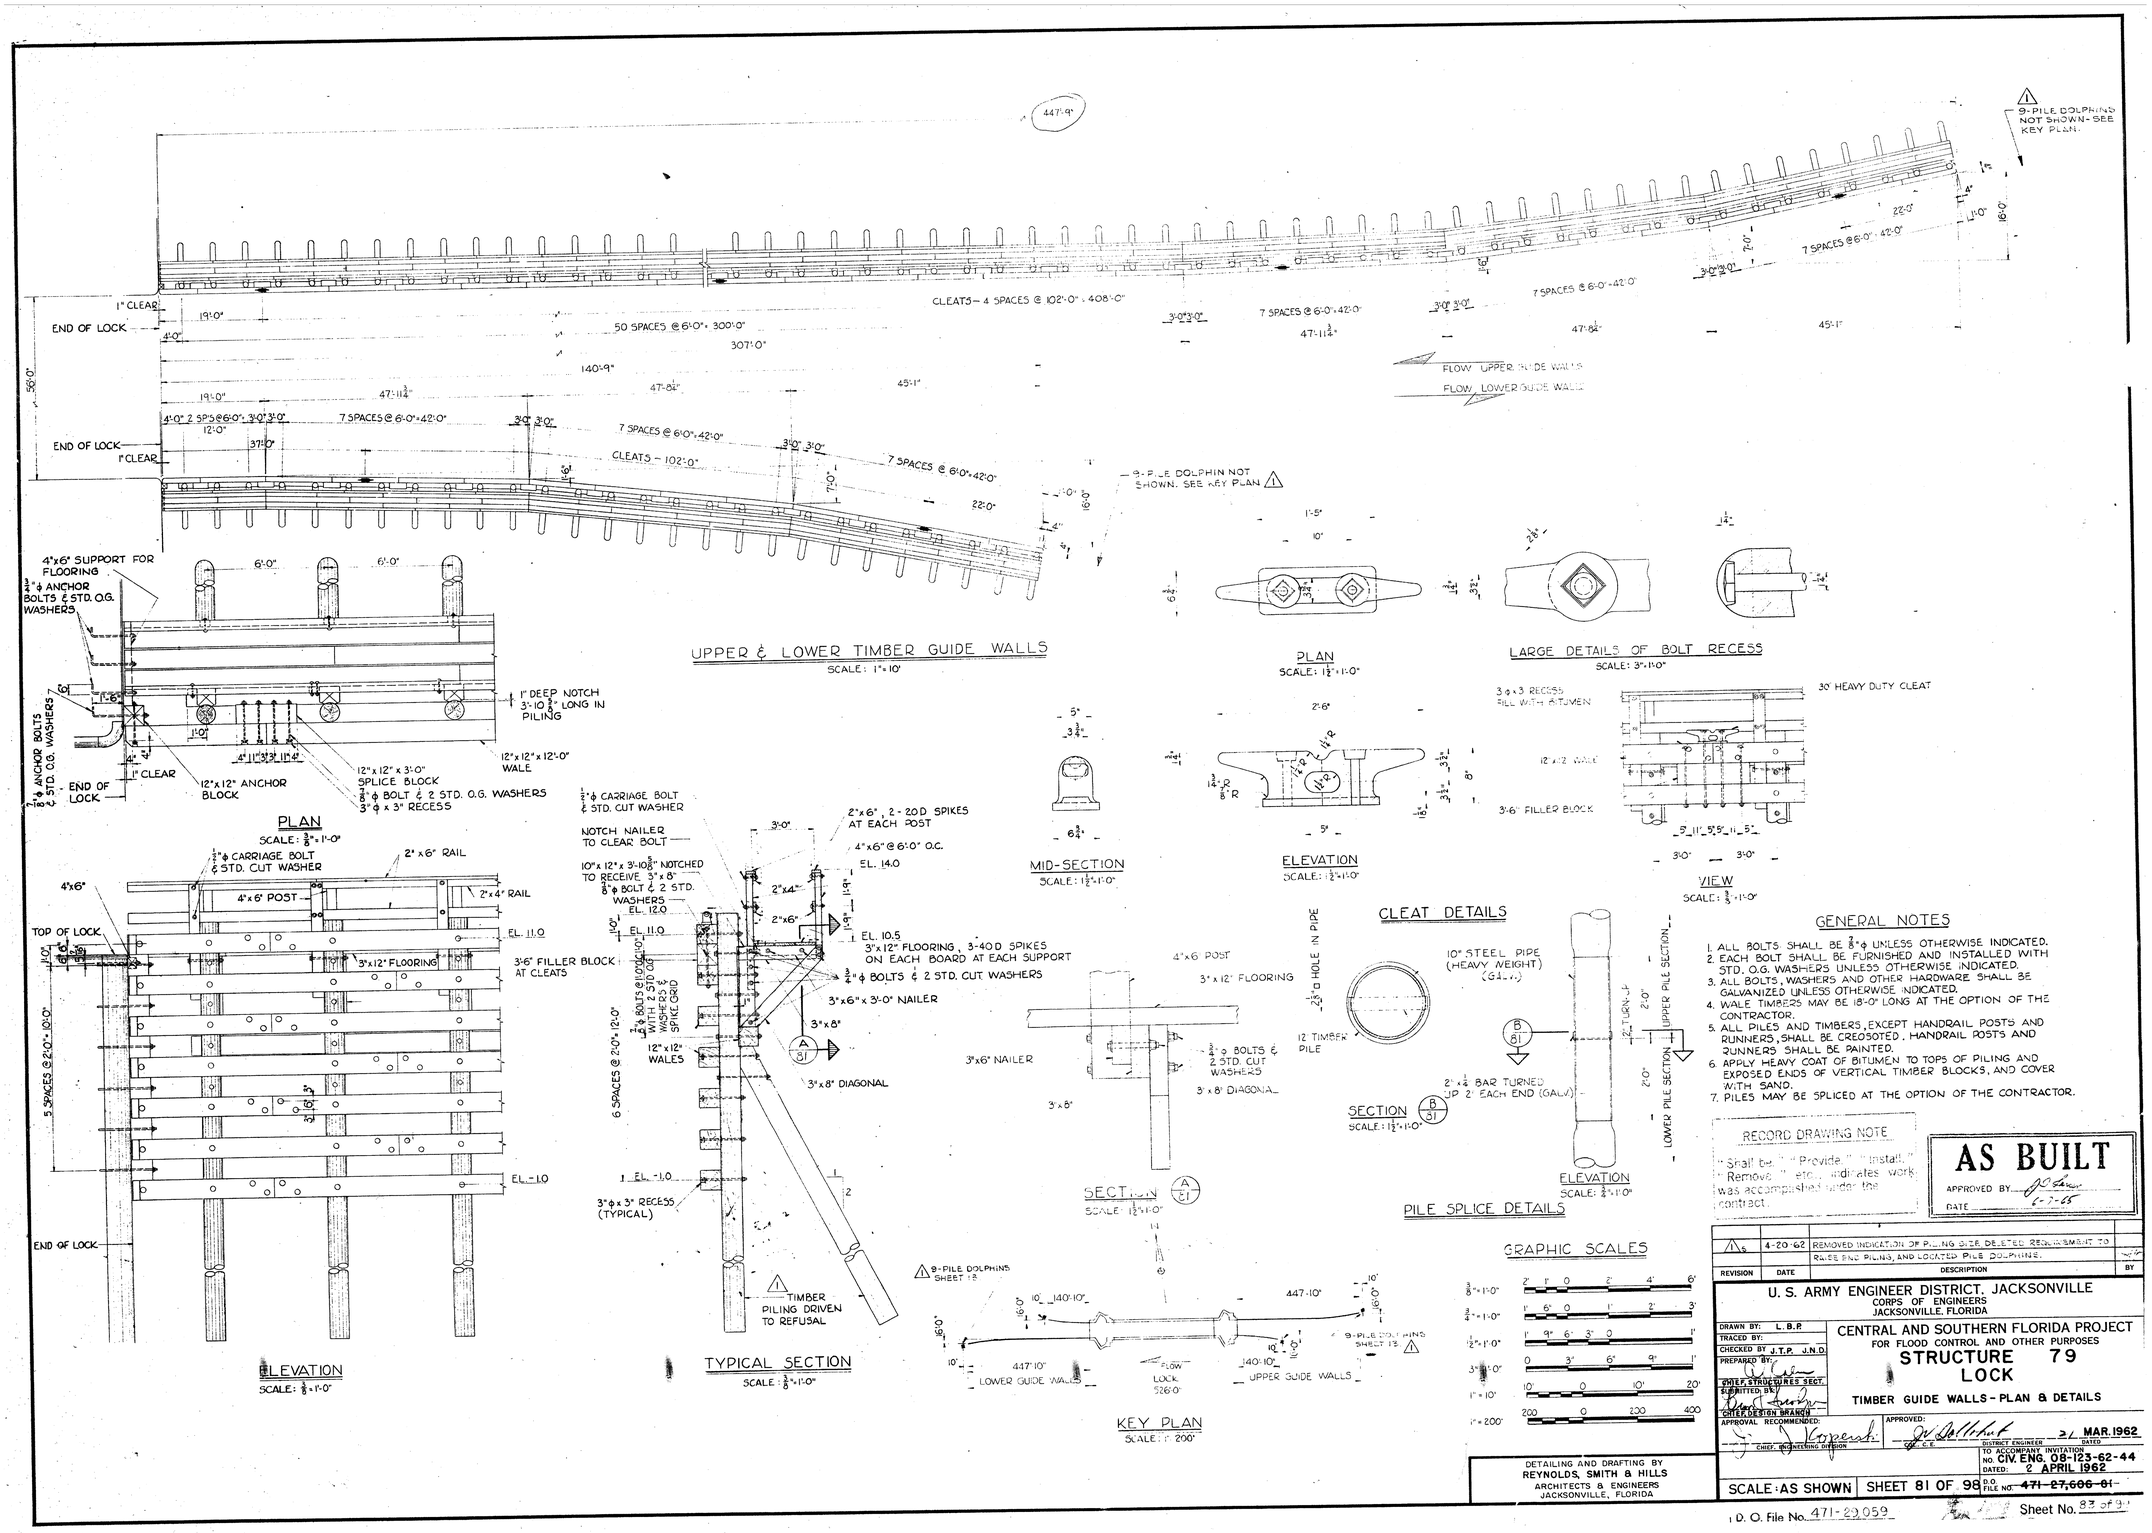

GENERAL NOTES

1. ALL BOLTS SHALL BE 7/8"φ UNLESS OTHERWISE INDICATED.
2. EACH BOLT SHALL BE FURNISHED AND INSTALLED WITH STD. O.G. WASHERS UNLESS OTHERWISE INDICATED.
3. ALL BOLTS, WASHERS AND OTHER HARDWARE SHALL BE GALVANIZED UNLESS OTHERWISE INDICATED.
4. WALE TIMBERS MAY BE 18'-0" LONG AT THE OPTION OF THE CONTRACTOR.
5. ALL PILES AND TIMBERS, EXCEPT HANDRAIL POSTS AND RUNNERS, SHALL BE CREOSOTED. HANDRAIL POSTS AND RUNNERS SHALL BE PAINTED.
6. APPLY HEAVY COAT OF BITUMEN TO TOPS OF PILING AND EXPOSED ENDS OF VERTICAL TIMBER BLOCKS, AND COVER WITH SAND.
7. PILES MAY BE SPLICED AT THE OPTION OF THE CONTRACTOR.

RECORD DRAWING NOTE

"Shall be," "Provide," "Install," "Remove," etc., indicates work was accomplished under the contract.

AS BUILT

APPROVED BY [signature]

DATE 6-7-65

REVISION	DATE	DESCRIPTION	BY
1	4-20-62	REMOVED INDICATION OF PILING SIZE DELETED REQUIREMENT TO RAISE END PILING, AND LOCATED PILE DOLPHINS.	

U. S. ARMY ENGINEER DISTRICT, JACKSONVILLE
CORPS OF ENGINEERS
JACKSONVILLE, FLORIDA

DRAWN BY: L.B.P.
TRACED BY:
CHECKED BY J.T.P. J.N.D.
PREPARED BY: [signature] CHIEF, STRUCTURES SECT.
SUBMITTED BY: [signature] CHIEF, DESIGN BRANCH
APPROVAL RECOMMENDED: [signature] CHIEF, ENGINEERING DIVISION
APPROVED: [signature] COL. C.E. DISTRICT ENGINEER 21 MAR. 1962 DATED

CENTRAL AND SOUTHERN FLORIDA PROJECT
FOR FLOOD CONTROL AND OTHER PURPOSES
STRUCTURE 79
LOCK
TIMBER GUIDE WALLS - PLAN & DETAILS

TO ACCOMPANY INVITATION NO. CIV. ENG. 08-123-62-44
DATED: 2 APRIL 1962
D.O. FILE NO. ~~471-27,606-61~~

SCALE: AS SHOWN | SHEET 81 OF 98

DETAILING AND DRAFTING BY
REYNOLDS, SMITH & HILLS
ARCHITECTS & ENGINEERS
JACKSONVILLE, FLORIDA

D. O. File No. 471-29,059 Sheet No. 83 of 91

US ARMY CORPS OF ENGINEERS
JACKSONVILLE DISTRICT

SAFETY ON THIS JOB DEPENDS ON YOU

NO.	SYMBOL	ZONE	DESCRIPTION	APPROVED
1	A	ALL	REVISED TO ACCOMPANY AMENDMENT NO. 0001	

DEPARTMENT OF THE ARMY
JACKSONVILLE DISTRICT, CORPS OF ENGINEERS
JACKSONVILLE, FLORIDA

URS GROUP INC.
7650 WEST COURTNEY
CAMPBELL CAUSEWAY
TAMPA, FL 33607-1462
NO. 00000002

DESIGNED BY:
DWN BY: Ckd by:
Inv. No. DACW17-02-B-0007
Dated:
Scale: AS SHOWN
Plot date:
Plot scale:

DATED: AUG 2001
D.O. FILE NO471-38,227

FILE NAME: 15-1.DGN
REFERENCE FILES: G-BRDR01.DGN

CENTRAL AND SOUTHERN FLORIDA PROJECT
FOR FLOOD CONTROL AND OTHER PURPOSES
REPLACEMENT OF TIMBER GUIDE WALLS AT W.P. FRANKLIN LOCK
STRUCTURE S-79
STRUCTURE S-79 (AS BUILT)
TIMBER GUIDE WALLS PLAN & DETAILS

DRAWING NO.
15/1

.../contract/15-1.dgn 06/20/2002 11:15:27 AM