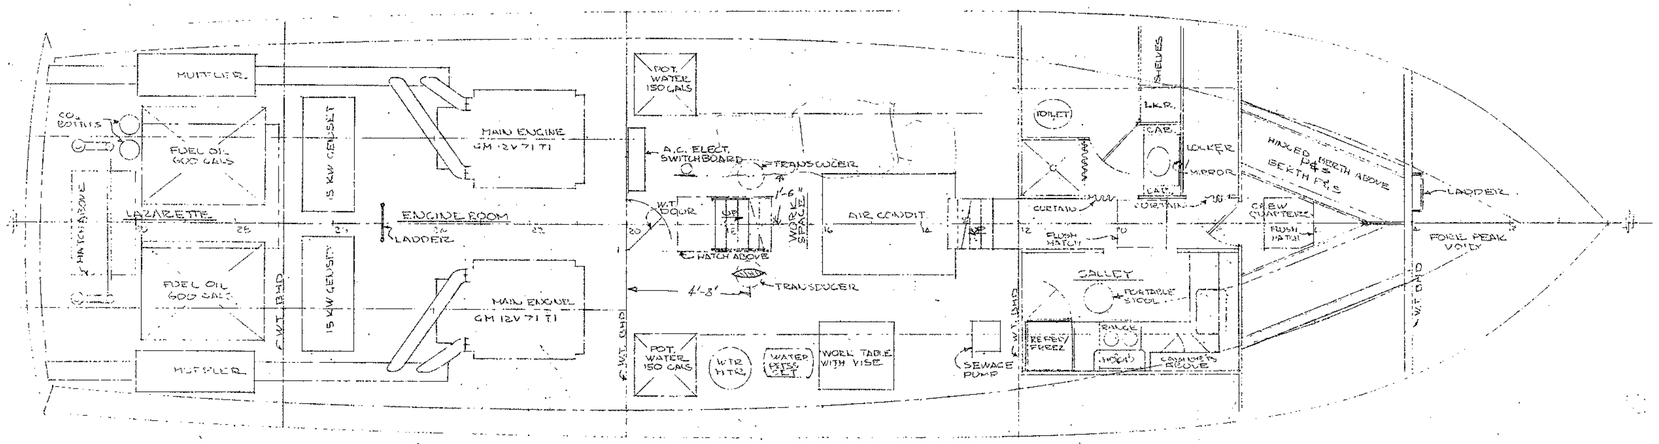

BELOW DECK PLAN
SCALE 3/8" = 1'-0"

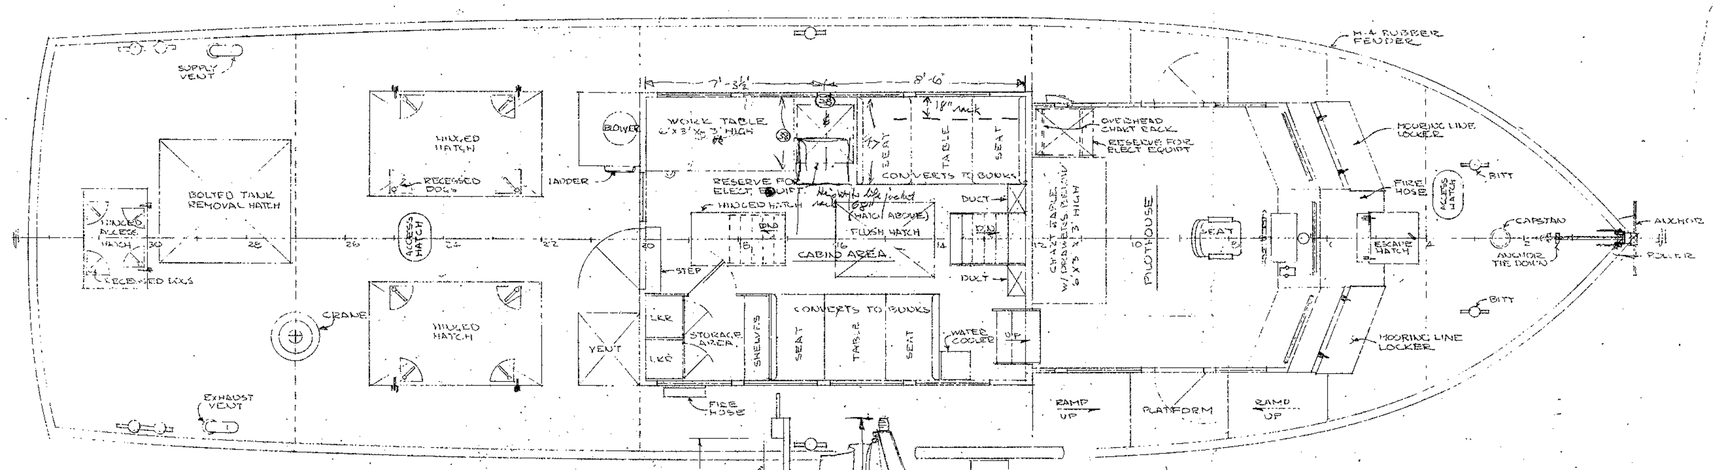

MAIN DECK PLAN
SCALE 3/8" = 1'-0"

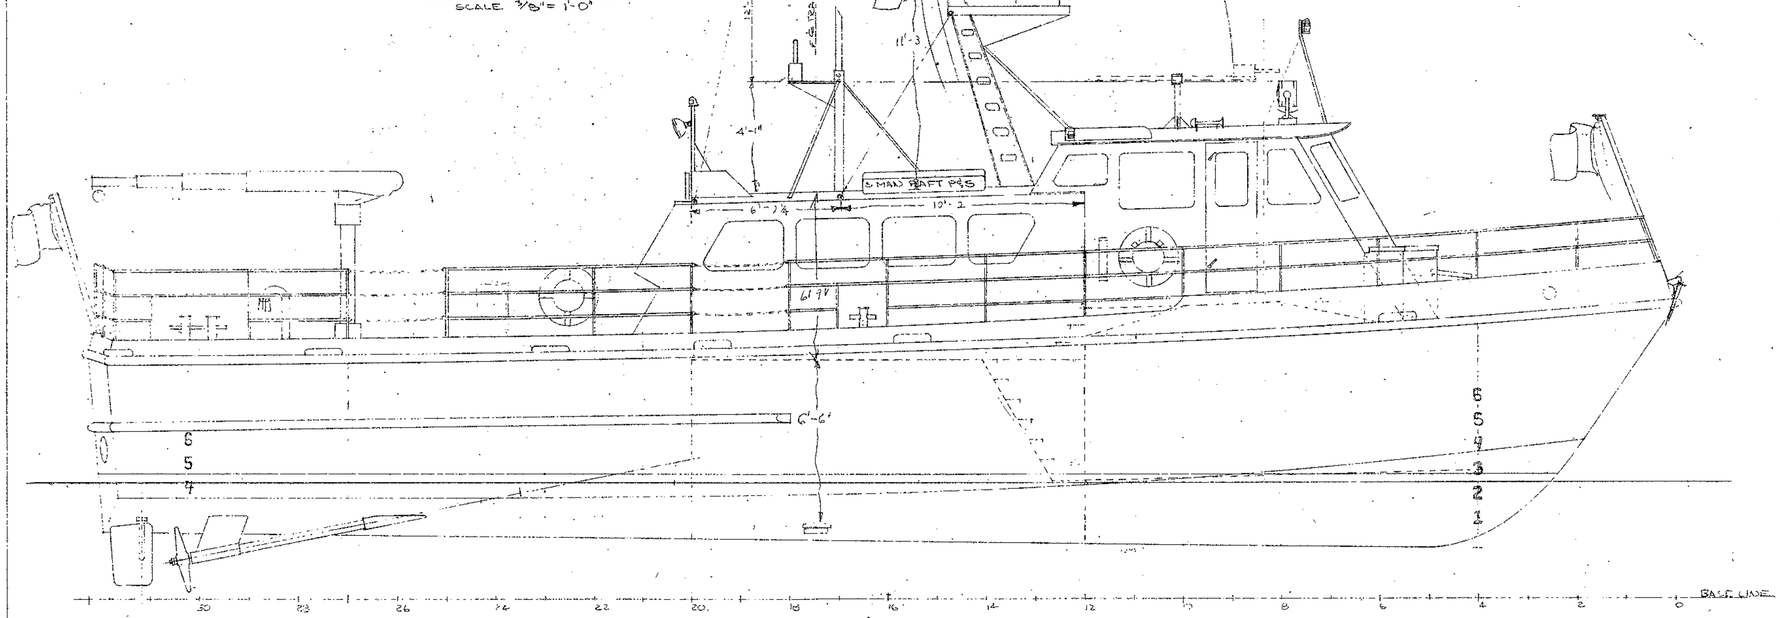

OUTBOARD PROFILE BEAM: 18'-1"
SCALE 3/8" = 1'-0"

MARIC FOR DOCKING

CHARACTERISTICS

LENGTH ON DECK (MLD)	64'-6"
BEAM (MLD)	17'-6"
DEPTH (MLD)	8'-2"
DESIGN DRAFT	4'-7"
FUEL OIL CAPACITY (DIESEL)	1200 GALS.
POT. WATER CAPACITY	300 GALS
CONSTRUCTION	ALUMINUM

SERVEY VESSEL
FLORIDA
DEPARTMENT OF THE ARMY
JACKSONVILLE DISTRICT, CORPS OF ENGINEERS

REV	DESCRIPTION	BY	DATE
5	REVISED AS BUILT	RK	[illegible]
4	REVISED PER USCG LETTER DATED 17 AUG. 1973	RK	SEPT 8-73
3	REVISED FOR ENG & ELECT. CHANGES	RK	[illegible] 8-73
2	REVISED PER C.O.E. LETTER DATED 9 MAY, 1973	RK	MAY 23-73
1	MOVED AFT DOOR OFF & ADDED VENTS BAKED CABIN AREA	RK	APR 23-73

REVISIONS

PROFILE & ARRANGEMENT
65' SURVEY BOAT
FOR DACW-17-73-[illegible]
DEPEND-A-CRAFT
RFD BOX 225, PIERRE [illegible]

HULL NO 23 MAR. 1973 DWG NO A-1
DESIGNED BY ROSS KRAMER
NEW [illegible]
REV 5