REVISIONS					
NO.	SYM.	ZONE	DESCRIPTION	DATE	APPROVED
11	3		Delete sta's. 1,5,9 & 16 add Guard Lts., revise	4/20/62	
			Location Rear S.W. added Conduit for P.A. system.		
1	2		Relocate cable trench - Mod J	8/3/63	
1B	4		Add Exp. fittings to accompany mod. to Cont. 62-102	7-1-64	

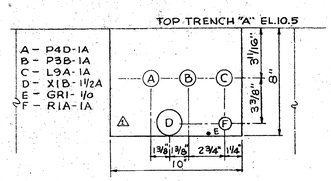

DETAIL "A"
CONDUIT ENTERING TRENCH "A"
FROM J.B. NO.2
SCALE: 3"=1'-0"

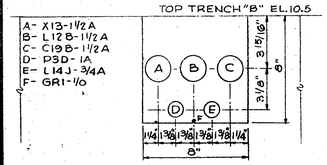

DETAIL "B"
CONDUIT ENTERING TRENCH "B"
FROM J.B. NO.3
SCALE: 3"=1'-0"

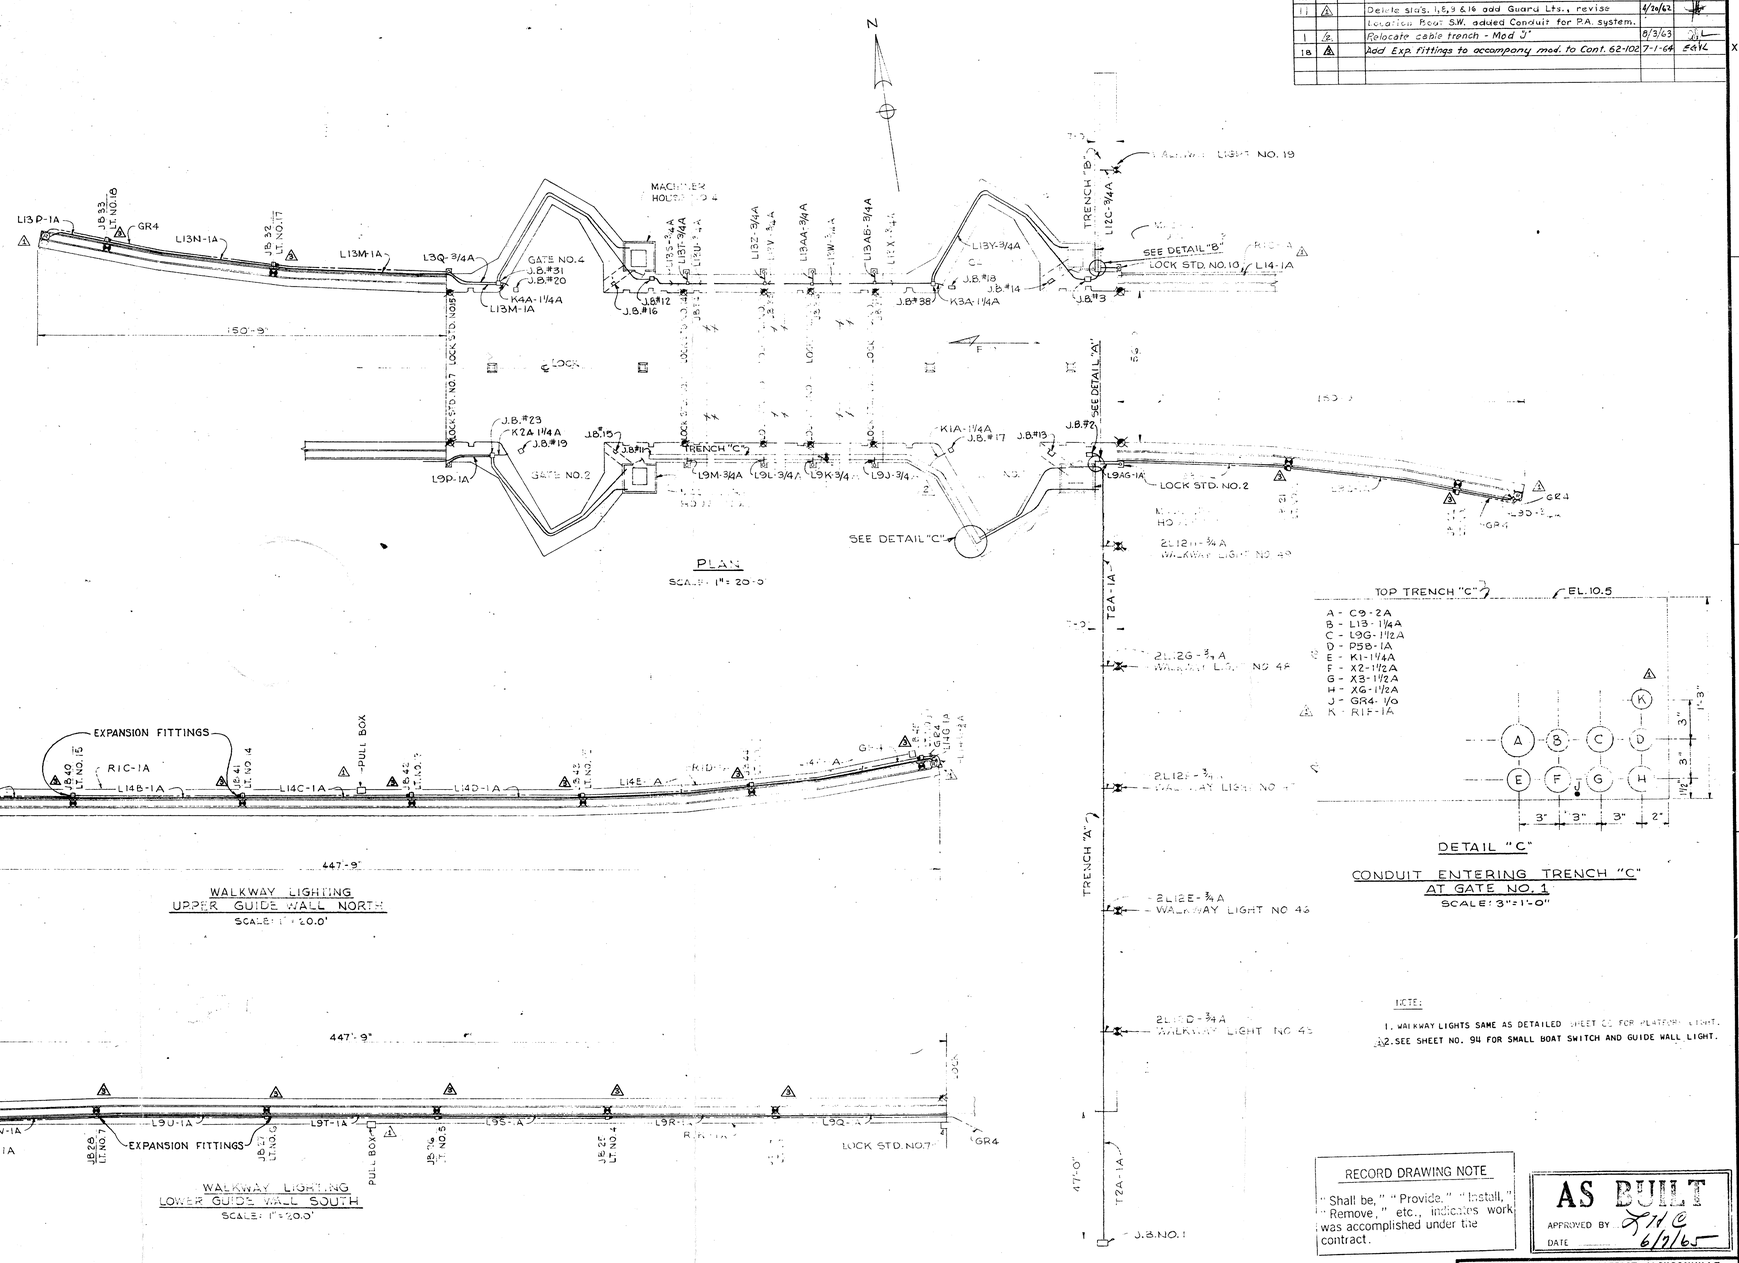

DETAIL "C"
CONDUIT ENTERING TRENCH "C"
AT GATE NO. 1
SCALE: 3"=1'-0"

NOTE:
1. WALKWAY LIGHTS SAME AS DETAILED SHEET 92 FOR PLATFORM LIGHT.
2. SEE SHEET NO. 94 FOR SMALL BOAT SWITCH AND GUIDE WALL LIGHT.

RECORD DRAWING NOTE
"Shall be," "Provide," "Install," "Remove," etc., indicates work was accomplished under the contract.

AS BUILT
APPROVED BY
DATE 6/7/65

U. S. ARMY ENGINEER DISTRICT, JACKSONVILLE
CORPS OF ENGINEERS
JACKSONVILLE, FLORIDA
CENTRAL AND SOUTHERN FLORIDA PROJECT
FOR FLOOD CONTROL AND OTHER PURPOSES
STRUCTURE 79
LOCK
CONDUIT LAYOUT

INVITATION NO. CIV. ENG-62-183-62-44	SIZE	FILE NO. ~~471-27,606~~
SCALE: AS SHOWN		SHEET 91 OF 98

D.O. File No. 471-29.059 SHEET 92 of 99

US ARMY CORPS OF ENGINEERS
JACKSONVILLE DISTRICT

SAFETY ON THIS JOB DEPENDS ON YOU

NO.	SYMBOL	ZONE	DESCRIPTION	APPROVED
1	3	ALL	REVISED TO ACCOMPANY AMENDMENT NO. 0001	

DEPARTMENT OF THE ARMY
JACKSONVILLE DISTRICT, CORPS OF ENGINEERS
JACKSONVILLE, FLORIDA

URS GROUP INC.
7650 WEST COURTNEY CAMPBELL CAUSEWAY
TAMPA, FL 33607-1462
NO. 000000002

DESIGNED BY: | Inv. No. DACW17-02-B-0007
DWN BY: | Chd by: | Dated:
Scale: AS SHOWN
Plot date:
Plot scale:
FILE NAME: 15-4.DGN
REFERENCE FILES: G-BRGR01.DGN

DATED: AUG 2001
D.O. FILE NO471-38,227

CENTRAL AND SOUTHERN FLORIDA PROJECT
FOR FLOOD CONTROL AND OTHER PURPOSES
REPLACEMENT OF TIMBER GUIDE WALLS AT W.P. FRANKLIN LOCK
STRUCTURE S-79
STRUCTURE S-79 (AS BUILT)
CONDUIT LAYOUT

DRAWING NO.
15/4

.../contract/15-4.dgn 06/20/2002 11:18:11 AM